

APPENDIX C
Utility As-Builts


H:\Jobs\20-024 Wasilla Airport Term (COW)\07 Master Plan\CAD\Drawings\Exhibits\Utility As-Builts\20024_07_Uilities.dwg, 1" = .1667', 12/05/2023 at 10:54 by JSE
 LAYOUT: GAS
 XREF: 17033_07_BD01



NATURAL GAS LEGEND	
	UNDERGROUND NATURAL GAS
	NATURAL GAS METER

NOTES:

1. ALL NATURAL GAS FACILITIES ARE OWNED BY ENSTAR NATURAL GAS.
2. UTILITY SURVEY WAS OBTAINED IN RESPONSE TO DESIGN LOCATE REQUEST(S) ON OCTOBER 20, 2022.
3. UTILITY SURVEY DATA WAS COLLECTED THROUGH GPS SURVEY CONDUCTED BY HDL ENGINEERING CONSULTANTS, LLC IN OCTOBER OF 2020.

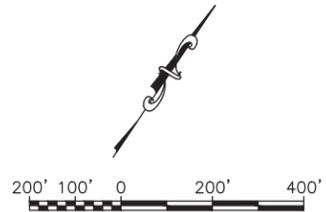

REVISIONS	MARK	DATE	DESCRIPTION
1			
2			
3			
4			
5			

HDL ENGINEERING
Consultants LLC
 civil - geotechnical - surveying - environmental - material testing
 ANCHORAGE MAT-SU KENAI
 907.564.2120 907.746.5230 907.283.2051
 3335 Arctic Boulevard, Suite 100 Anchorage, AK 99503
 AECL861 www.HDLalaska.com


MASTER PLAN
WASILLA MUNICIPAL AIRPORT
 WASILLA, ALASKA

SHEET TITLE
 UTILITY ASBUILT
 NATURAL GAS

SHEET
1 OF 4

DRAWN BY: JSE CHECKED BY:
 DATE: MAY 2023 SCALE: 1"=200'
 JOB NUMBER: 20-024

H:\Jobs\20-024 Wasilla Airport Term (COW)\07 Master Plan\CAD\Drawings\Exhibits\Utility As-Builts\20024_07_Utillities.dwg, 1" = .1667', 12/05/2023 at 16:23 by JSE
 LAYOUT: ELECTRIC
 XREF: 17033_07_BD01

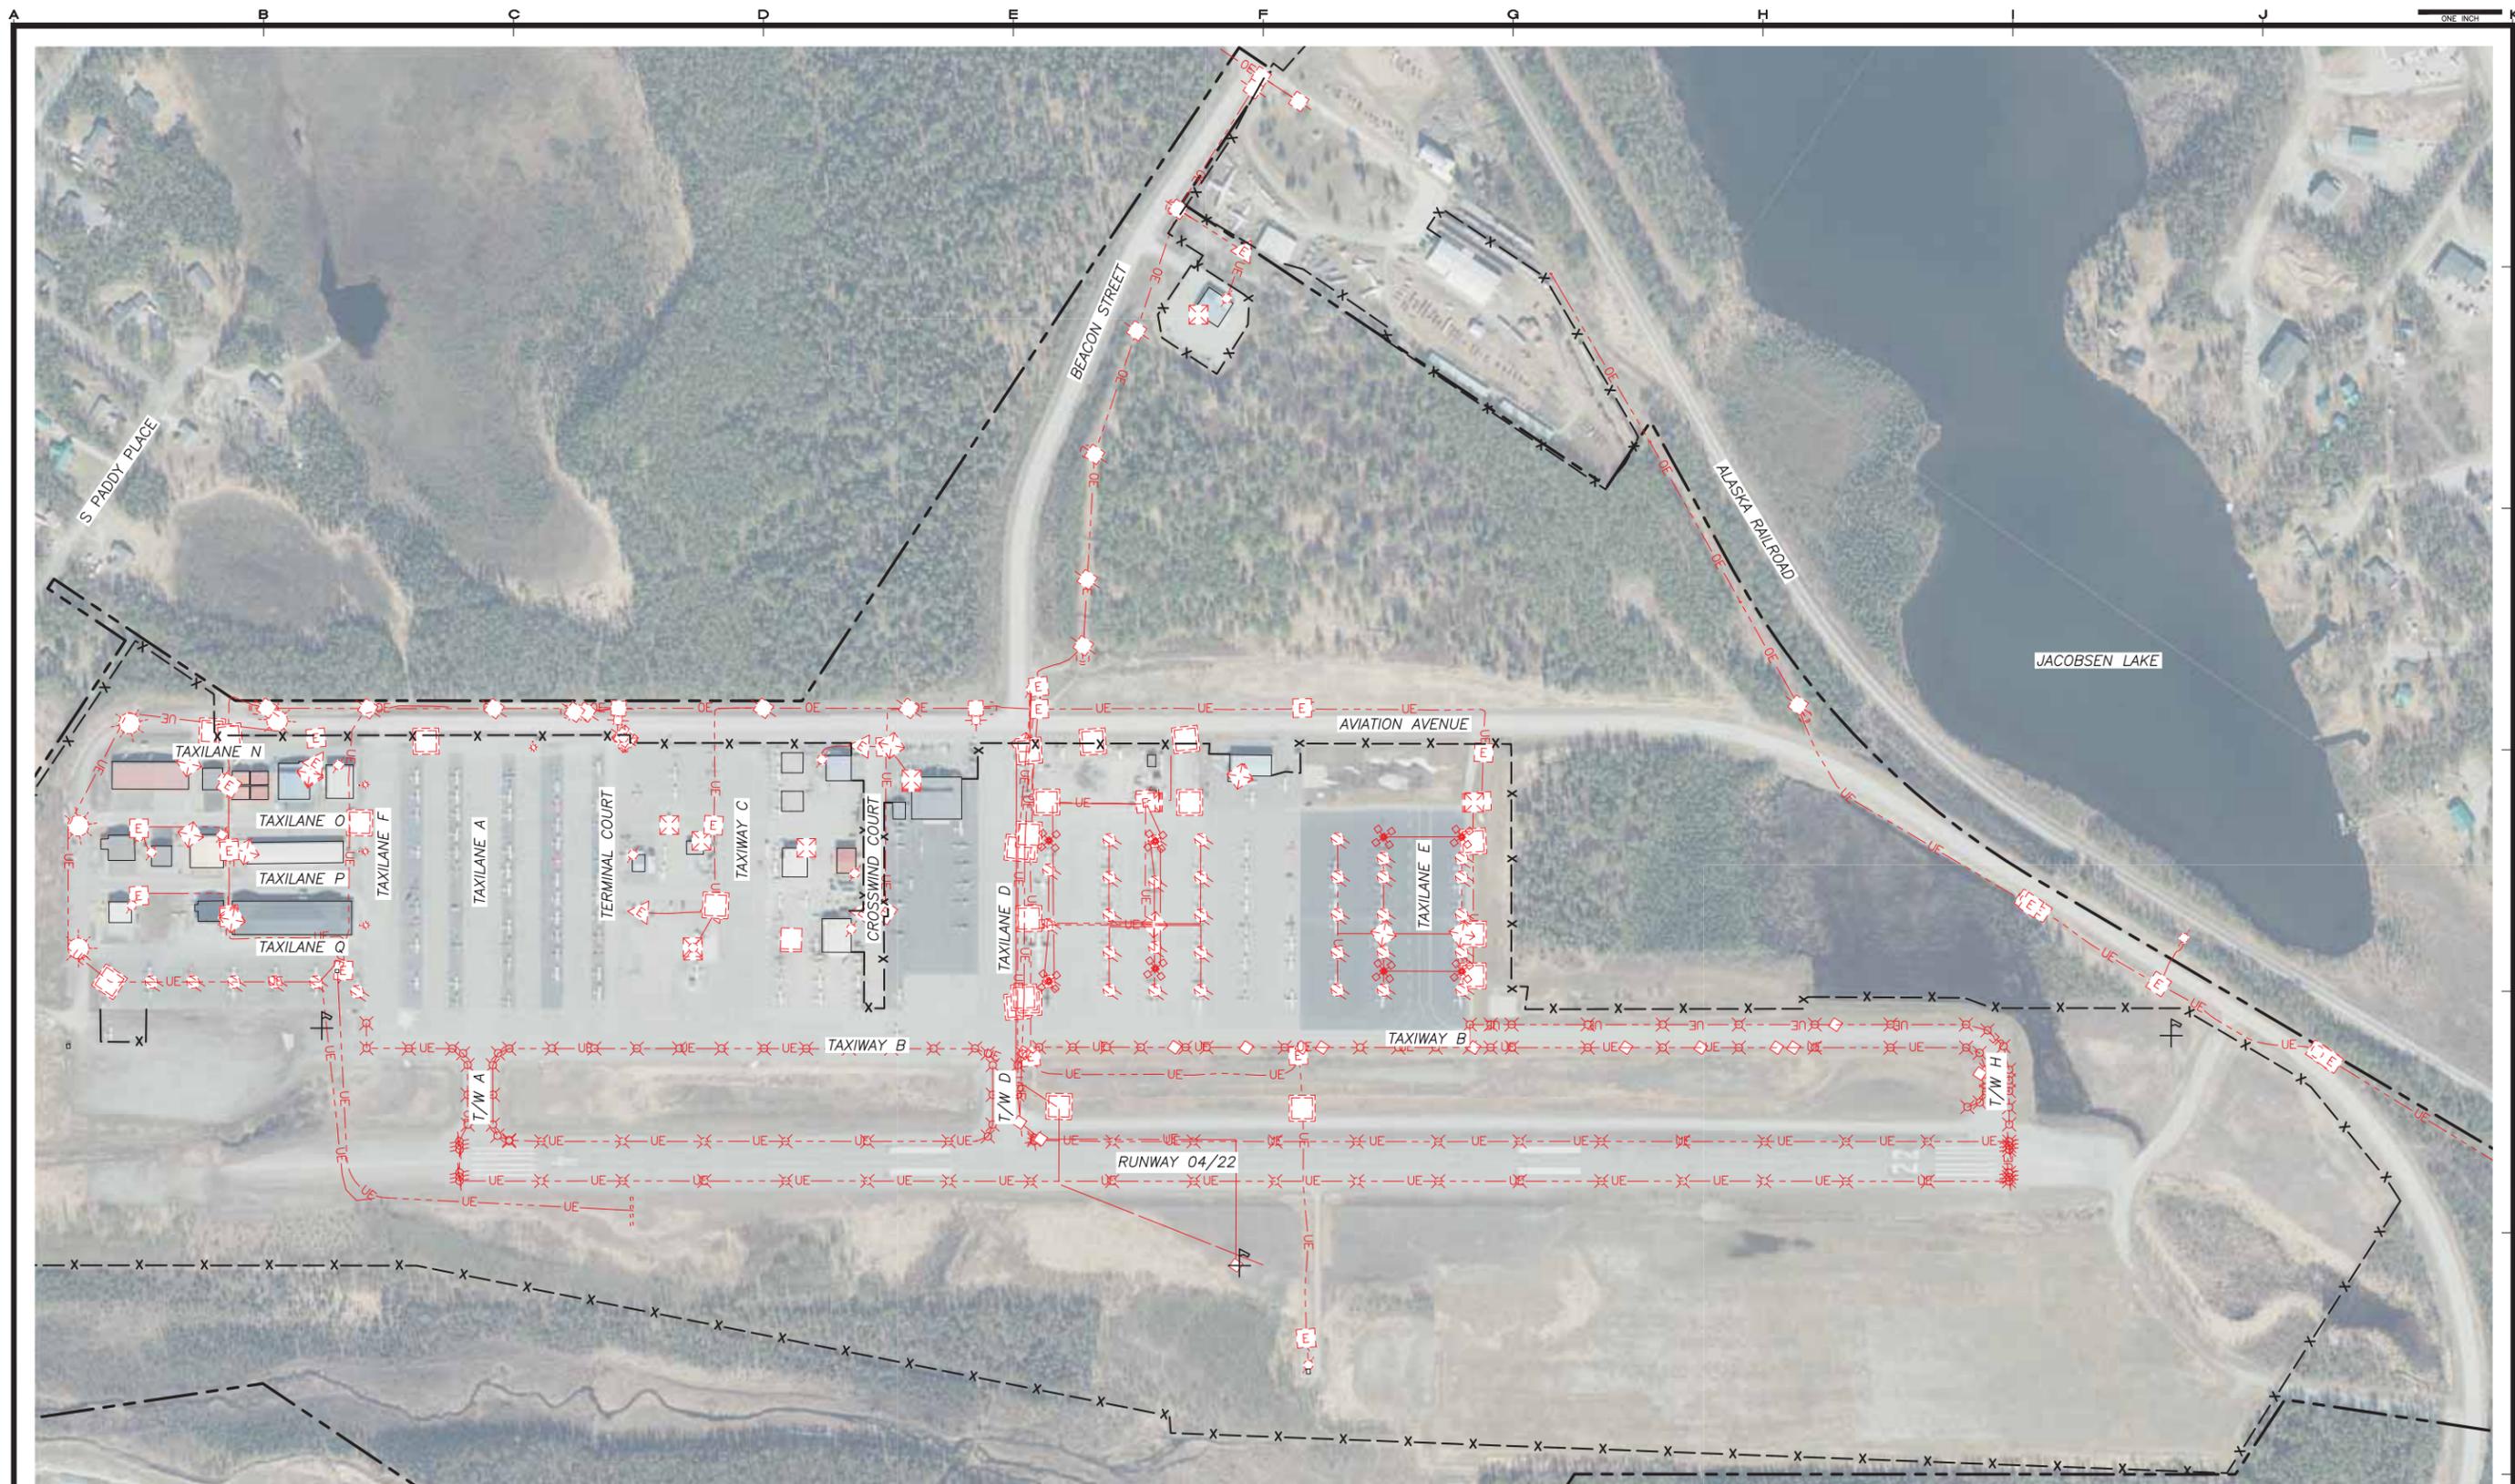


ELECTRICAL LEGEND

---	UE	UNDERGROUND ELECTRIC	⊕	ELECTRIC METER	⊕	LIGHT POLE
---	OE	OVERHEAD ELECTRIC	⊕	GUY ANCHOR	⊕	JUNCTION BOX
⊕		TRANSFORMER	⊕	TRAFFIC LIGHT POLE		
⊕		SWITCH	⊕	ELECTRICAL OUTLET		
⊕		ELECTRICAL PEDESTAL	⊕	AVIATION LIGHT		
⊕		UTILITY POLE	⊕	LIGHT POLE WITH 4 LIGHTS		

NOTES:

1. THE ELECTRICAL FACILITIES SHOWN ARE OWNED BY MATANUSKA ELECTRIC ASSOCIATION (MEA), FEDERAL AVIATION ADMINISTRATION (FAA), OR CITY OF WASILLA.
2. UTILITY SURVEY WAS OBTAINED IN RESPONSE TO DESIGN LOCATE REQUEST(S) ON OCTOBER 20, 2022.
3. UTILITY SURVEY DATA WAS COLLECTED THROUGH GPS SURVEY CONDUCTED BY HDL ENGINEERING CONSULTANTS, LLC IN OCTOBER OF 2020.

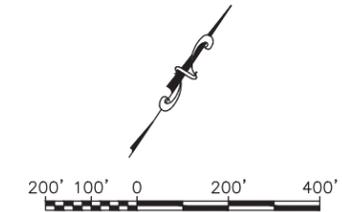

REVISIONS	MARK	DATE	DESCRIPTION
1			
2			
3			
4			
5			

HDL ENGINEERING
Consultants LLC
 civil - geotechnical - surveying - environmental - material testing
 ANCHORAGE MAT-SU KENAI
 907.564.2120 907.746.5230 907.283.2051
 3335 Arctic Boulevard, Suite 100 Anchorage, AK 99503
 www.HDLalaska.com
 AECL861

MASTER PLAN
WASILLA MUNICIPAL AIRPORT
 WASILLA, ALASKA

SHEET TITLE
 UTILITY ASBUILT
 ELECTRICAL

SHEET
 2 OF 4

DRAWN BY: JSE CHECKED BY:
 DATE: MAY 2023 SCALE: 1"=200'
 JOB NUMBER: 20-024


H:\Jobs\20-024 Wasilla Airport Term (COW)\07 Master Plan\CAD\Drawings\Exhibits\Utility As-Builts\20024_07_Uilities.dwg, 1" = .1667', 12/05/2023 at 10:54 by JSE
 LAYOUT: COMMUNICATIONS
 XREF: 17033_07_BD01



TELECOMMUNICATION LEGEND	
	UNDERGROUND FIBER OPTIC
	UNDERGROUND TELECOMMUNICATIONS
	TELECOMMUNICATIONS PEDESTAL
	FIBER OPTIC VAULT
	TELECOMMUNICATION SERVICE BOX

NOTES:

1. THE TELECOMMUNICATION FACILITIES SHOWN ARE OWNED BY MATANUSKA TELEPHONE ASSOCIATION (MTA). ALL OTHERS ARE OWNED BY THE FEDERAL AVIATION ADMINISTRATION (FAA) OR THE CITY OF WASILLA.
2. UTILITY SURVEY WAS OBTAINED IN RESPONSE TO DESIGN LOCATE REQUEST(S) ON OCTOBER 20, 2022.
3. UTILITY SURVEY DATA WAS COLLECTED THROUGH GPS SURVEY CONDUCTED BY HDL ENGINEERING CONSULTANTS, LLC IN OCTOBER OF 2020.

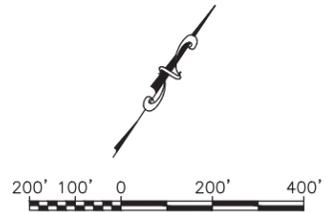

REVISIONS	MARK	DATE	DESCRIPTION
1			
2			
3			
4			
5			

HDL ENGINEERING
Consultants LLC
 civil - geotechnical - surveying - environmental - material testing
 ANCHORAGE MAT-SU KENAI
 907.564.2120 907.746.5230 907.283.2051
 3335 Arctic Boulevard, Suite 100 Anchorage, AK 99503
 www.HDLalaska.com

MASTER PLAN
WASILLA MUNICIPAL AIRPORT
 WASILLA, ALASKA

SHEET TITLE
 UTILITY ASBUILT
 TELECOMMUNICATIONS

SHEET
3 OF 4

DRAWN BY: JSE CHECKED BY:
 DATE: MAY 2023 SCALE: 1"=200'
 JOB NUMBER: 20-024

H:\Jobs\20-024 Wasilla Airport Term (COW)\07 Master Plan\CAD\Drawings\Exhibits\Utility As-Builts\20024_07_Uilities.dwg, 1" = .1667', 12/05/2023 at 10:54 by JSE
 LAYOUT: OTHERS
 XREF: 17033_07_BD01



REVISIONS	MARK	DATE	DESCRIPTION
1			
2			
3			
4			
5			

HDL ENGINEERING
Consultants LLC
 civil - geotechnical - surveying - environmental - material testing
 ANCHORAGE MAT-SU KENAI
 907.564.2120 907.746.5230 907.283.2051
 3335 Arctic Boulevard, Suite 100 Anchorage, AK 99503
 AECL861 www.HDLalaska.com

MASTER PLAN
WASILLA MUNICIPAL AIRPORT
 WASILLA, ALASKA

SHEET TITLE
 UTILITY ASBUILT

ONSITE WATER, SEPTIC AND STORM DRAIN

SHEET
4 OF 4

DRAWN BY: JSE CHECKED BY:
 DATE: MAY 2023 SCALE: 1"=200'
 JOB NUMBER: 20-024

	SEPTIC CLEANOUT OR INSPECTION STANDPIPE		STORM DRAIN MANHOLE
	WATER WELL		WATER VALVE BOX
	WATER SERVICE KEY BOX		WATER HYDRANT
	SANITARY SEWER SERVICE CLEANOUT		CULVERT
	STORM DRAIN FIELD INLET		

NOTES:

- UTILITY SURVEY WAS OBTAINED IN RESPONSE TO DESIGN LOCATE REQUEST(S) ON OCTOBER 20, 2022.
- UTILITY SURVEY DATA WAS COLLECTED THROUGH GPS SURVEY CONDUCTED BY HDL ENGINEERING CONSULTANTS, LLC IN OCTOBER OF 2020.

